

**Work Order ID-56491**

February 25, 2010 7:32:43 AM

Page 1

Item ID: D3391-023

Accept

Revision ID:

Item Name: Mid Tube Assembly

Start Date: 2/25/10 Start Qty: 1.00

Required Date: 3/05/10 Req'd Qty: 1.00

Reference:

Approvals: Process Plan:

Date:

Tooling:

Date:

Run Start

QC:

Date:

SPC (Y/N):

Date:

Stop

Sequence ID/  
Work Center IDOperation  
DescriptionSet Up/  
Run HoursDraw  
NumberDraw  
Rev.Plan  
CodeAccept  
QtyReject  
QtyReject  
NumberInsp.  
Stamp

Draw Nbr

Revision Nbr

D3391

Rev H

100

0.00



Skidtubes

Skidtubes

Skidtubes

Memo

0.00

1-Cut tube to finish length as per Dwg D3391

2-Identify as D3391-023

3-Drill pilot holes using DT8796 (Do not drill "B" holes) and drill only 1 fwd saddle hole on one side only as per Dwg D3391

4-Open saddles and GHW holes to Ø0.375" except for fwd saddle hole of detail "J"

5-Remove .030" from Fwd indexing Ridge as per Dwg D3391

6-Remove indexing ridge on Fwd &amp; Aft end of skidtube as per Dwg D3391

7-Deburr

8-Drill #30 pilot holes using wearplate Jig DT8217 Identify Ø0.250" holes with paint marker,

9-Open wearplate holes of D3391-023 assembly detail section G-G to Ø0.250" (14 holes) as per Dwg D3391 and 2 holes in section Detail "J", do not open wearplate holes of section "J"

10-Open wearplate holes of D3391-023 assembly detail section H-H to Ø0.297" (20 holes) as per Dwg D3391

4/10/2/25

| W/O: |      | WORK ORDER CHANGES |    |      |     |                                     |                          |
|------|------|--------------------|----|------|-----|-------------------------------------|--------------------------|
| DATE | STEP | PROCEDURE CHANGE   | By | Date | Qty | Approval<br>Chief Eng /<br>Prod Mgr | Approval<br>QC Inspector |
|      |      |                    |    |      |     |                                     |                          |
|      |      |                    |    |      |     |                                     |                          |

Part No: \_\_\_\_\_ PAR #: \_\_\_\_\_ Fault Category: \_\_\_\_\_ NCR: Yes No DQA: \_\_\_\_\_ Date: \_\_\_\_\_

Resolution: \_\_\_\_\_ Disposition: \_\_\_\_\_ QA: N/C Closed: \_\_\_\_\_ Date: \_\_\_\_\_

| NCR: |      | WORK ORDER NON-CONFORMANCE (NCR) |                             |                                 |                |                           |                       |                          |
|------|------|----------------------------------|-----------------------------|---------------------------------|----------------|---------------------------|-----------------------|--------------------------|
| DATE | STEP | Description of NC<br>Section A   | Corrective Action Section B |                                 |                | Verification<br>Section C | Approval<br>Chief Eng | Approval<br>QC Inspector |
|      |      |                                  | Initial<br>Chief Eng        | Action Description<br>Chief Eng | Sign &<br>Date |                           |                       |                          |
|      |      |                                  |                             |                                 |                |                           |                       |                          |
**NOTE:** Date & initial all entries

# Work Order ID 56491

February 25, 2010 7:32:44 AM



Page 2

Item ID: D3391-023

Accept



Setup Start



Revision ID:

Stop



Item Name: Mid Tube Assembly

Start Date: 2/25/10 Start Qty: 1.00



Cust Item ID:

Required Date: 3/05/10 Req'd Qty: 1.00



Customer:

Reference:

Approvals: Process Plan:

Date:

Tooling:

Date:

Run Start



QC:

Date:

SPC (Y/N):

Date:

Stop



Sequence ID/  
Work Center ID

Operation  
Description

Set Up/  
Run Hours

Draw  
Number

Draw  
Rev.

Plan  
Code

Accept  
Qty

Reject  
Qty

Reject  
Number

Insp.  
Stamp

11-Open .375" holes to .438" \*\*\*do not open fwd saddle holes\*\*\*

4 0/2/25

12-Locate D3391-021 in D3391-023 at 9.00" (see view z-z)

13- Transfer drill one fwd saddle hole only to .188" dia, transfer drill all remaining fwd saddle holes using DT 8149 locating from previously drill .188" dia hole, using t-pins and clicos to ensure perfect allingment, open up previously tranfer drilled pilot holes in D3391-023/-021 to 0.438" dia. in D3391-021

4 0/3/11

14- Transfer drill 2 wearplate holes into D3391-021 using DT8217, locating from two previously drilled holes, drill remaining wearplate holes into D3391-021.

15- Locating from two fwd wearplate holes drilol remaining 6 wearplate holes in D3391-021 using DT8937

16- Open 2 fwd wearplate holes in D3391-023 to .250" dia.

17- counterbore two aft wearplate holes in D3391-021 as per dwg

18- Open 12 wearplate holes in D3391-021 to 0.297" dia.

19-Deburr and blow out all chips from inside tube

| W/O: |      | WORK ORDER CHANGES |    |      |     |                                     |                          |
|------|------|--------------------|----|------|-----|-------------------------------------|--------------------------|
| DATE | STEP | PROCEDURE CHANGE   | By | Date | Qty | Approval<br>Chief Eng /<br>Prod Mgr | Approval<br>QC Inspector |
|      |      |                    |    |      |     |                                     |                          |
|      |      |                    |    |      |     |                                     |                          |

Part No: \_\_\_\_\_ PAR #: \_\_\_\_\_ Fault Category: \_\_\_\_\_ NCR: Yes No DQA: \_\_\_\_\_ Date: \_\_\_\_\_

Resolution: \_\_\_\_\_ Disposition: \_\_\_\_\_ QA: N/C Closed: \_\_\_\_\_ Date: \_\_\_\_\_

| NCR: |      | WORK ORDER NON-CONFORMANCE (NCR) |                                |                                 |                |                           |                       |                          |
|------|------|----------------------------------|--------------------------------|---------------------------------|----------------|---------------------------|-----------------------|--------------------------|
| DATE | STEP | Description of NC<br>Section A   | Corrective Action<br>Section B |                                 |                | Verification<br>Section C | Approval<br>Chief Eng | Approval<br>QC Inspector |
|      |      |                                  | Initial<br>Chief Eng           | Action Description<br>Chief Eng | Sign &<br>Date |                           |                       |                          |
|      |      |                                  |                                |                                 |                |                           |                       |                          |
**NOTE:** Date & initial all entries

# Work Order ID 56491

February 25, 2010 7:32:45 AM

Page 3

Item ID: D3391-023

Accept

Revision ID:

Item Name: Mid Tube Assembly

Start Date: 2/25/10 Start Qty: 1.00

Required Date: 3/05/10 Req'd Qty: 1.00

Reference:

Approvals: Process Plan:

Date:

Tooling:

Date:

Run Start

QC:

Date:

SPC (Y/N):

Date:

Stop

Sequence ID/  
Work Center ID

Operation  
Description

Set Up/  
Run Hours

Draw  
Number

Draw  
Rev.

Plan  
Code

Accept  
Qty

Reject  
Qty

Reject  
Number

Insp.  
Stamp

110

QC5- Inspect part completeness to step on W/O

0.00



QC

Memo

0.00

Quality Control

120

Chemical Conversion Coat per QSI005 4.1

0.00



HandFinish

Memo

0.00

Hand Finishing

130

QC3- Inspect Part Finish

0.00



QC

Memo

0.00

Quality Control



Setup

Start



Stop



Cust Item ID:

Customer:

Run

Start



Stop



8106361

⑩

BE 10/03/02

⑨

M 0/3/2

| W/O: |      | WORK ORDER CHANGES |    |      |     |                                     |                          |
|------|------|--------------------|----|------|-----|-------------------------------------|--------------------------|
| DATE | STEP | PROCEDURE CHANGE   | By | Date | Qty | Approval<br>Chief Eng /<br>Prod Mgr | Approval<br>QC Inspector |
|      |      |                    |    |      |     |                                     |                          |
|      |      |                    |    |      |     |                                     |                          |

Part No: \_\_\_\_\_ PAR #: \_\_\_\_\_ Fault Category: \_\_\_\_\_ NCR: Yes No DQA: \_\_\_\_\_ Date: \_\_\_\_\_

Resolution: \_\_\_\_\_ Disposition: \_\_\_\_\_ QA: N/C Closed: \_\_\_\_\_ Date: \_\_\_\_\_

| NCR: |      | WORK ORDER NON-CONFORMANCE (NCR) |                             |                                 |                |                           |                       |                          |
|------|------|----------------------------------|-----------------------------|---------------------------------|----------------|---------------------------|-----------------------|--------------------------|
| DATE | STEP | Description of NC<br>Section A   | Corrective Action Section B |                                 |                | Verification<br>Section C | Approval<br>Chief Eng | Approval<br>QC Inspector |
|      |      |                                  | Initial<br>Chief Eng        | Action Description<br>Chief Eng | Sign &<br>Date |                           |                       |                          |
|      |      |                                  |                             |                                 |                |                           |                       |                          |
NOTE: Date & initial all entries

# Work Order ID 56491

February 25, 2010 7:32:45 AM

Page 4

Item ID: D3391-023

Accept

Revision ID:

Item Name: Mid Tube Assembly

Setup Start

Stop

Start Date: 2/25/10 Start Qty: 1.00

Required Date: 3/05/10 Req'd Qty: 1.00

Cust Item ID:

Customer:

Reference:

Approvals: Process Plan:

Date:

Tooling:

Date:

Run Start

QC:

Date:

SPC (Y/N):

Date:

Stop

Sequence ID/  
Work Center ID

Operation  
Description

Set Up/  
Run Hours

Draw  
Number

Draw  
Rev.

Plan  
Code

Accept  
Qty

Reject  
Qty

Reject  
Number

Insp.  
Stamp

140



Skidtubes

Skidtubes

Skidtubes

Memo

0.00

1-Open float bag holes as per dwg  
2-C'sink float bag holes as per dwg  
3- Prepare tube for welding  
4-Bond web in place as per Dwg D3391 & QSI 015.  
Adhere for 12 hours)  
A/R Sikaflex exp: 08/2010  
batch#: M112429

BE 10/03/02

150



QC

Quality Control

QC5- Inspect part completeness to step on W/O

0.00

Memo

0.00

DP 10-3-3

160



Skidtubes

Skidtubes

Skidtubes

Memo

0.00

1-Weld crossbolt spacer as per dwg D3391 & QSI 004  
2-grind weld flush

BE 10/03/03

# Work Order ID 56491

February 25, 2010 7:32:46 AM

Page 5

Item ID: D3391-023

Accept

Revision ID:

Item Name: Mid Tube Assembly

Start Date: 2/25/10 Start Qty: 1.00

Required Date: 3/05/10 Req'd Qty: 1.00

Reference:

Cust Item ID:

Customer:

Approvals: Process Plan:

Date:

Tooling:

Date:

Run Start

QC:

Date:

SPC (Y/N):

Date:

Stop

Sequence ID/  
Work Center ID

Operation  
Description

Set Up/  
Run Hours

Draw  
Number

Draw  
Rev.

Plan  
Code

Accept  
Qty

Reject  
Qty

Reject  
Number

Insp.  
Stamp

170

QC10- Inspect visual per QSI004- ground welds

0.00

*Solo 10/5/05*

0.00

QC

Memo

Quality Control

180

QC5- Inspect part completeness to step on W/O

0.00

*Solo 10/5/05*

0.00

QC

Memo

Quality Control

185

*— pressure wash*  
*— Reallocate as per PAR09-043*

*= 7 m-h 10/05/05*

*(XL)*

*(1X)*

190

White Gloss(Ref:4.3.5.1) per QSI005 4.3-Alum

0.00

*= 1/4 10/05/05*

0.00

Powdercoat

Memo

Powder Coating

START TIME: *1:30pm*  
OVEN TEMPERATURE: *320°F*  
FINISH TIME: *2:00pm*



# Work Order ID 56491

February 25, 2010 7:32:53 AM

Page 6

Item ID: D3391-023

Revision ID:

Item Name: Mid Tube Assembly

Start Date: 2/25/10 Start Qty: 1.00

Required Date: 3/05/10 Req'd Qty: 1.00

Reference:

Approvals: Process Plan:

QC:

Date:

Date:

Tooling:

SPC (Y/N):

Date:

Date:

Run Start

Stop

Sequence ID/  
Work Center ID

200



QC

Quality Control

Operation  
Description

QC3- Inspect Part Finish

Memo

Set Up/  
Run Hours

0.00

Draw  
Number

0.00

Draw  
Rev.

Plan  
Code

Accept  
Qty

Reject  
Qty

Reject  
Number

Insp.  
Stamp

= 7 m-l 10/05/10

210



Skidtubes

Skidtubes

Skidtubes

Memo

0.00

0.00

= 7 m-l 10/07/07 xl ø

1- insert D3391-021 into D3391-23

2- insert T-pins into first and third fwd saddle holes

3- ON FIRST SIDE ONLY drill out 2nd and forth fwd saddles holes to 0.500" as per DSI 9364

4- remove T-pins and locate DT9415 from first and third crossbolt hole using T-pins and clekos

5- ON 2ND SIDE ONLY ream out 2nd and forth saddle hole to 0.499". Remove DT9415

6- deburr, re-alodine and blow out chips

7- press fit D3591-1 spacers using DT9416 starting from 0.500" side

# Work Order ID 56491

February 25, 2010 7:32:53 AM

Page 7

Item ID: D3391-023

Accept

Revision ID:

Item Name: Mid Tube Assembly

Start Date: 2/25/10 Start Qty: 1.00

Required Date: 3/05/10 Req'd Qty: 1.00

Reference:

Approvals: Process Plan:

Date:

Tooling:

Date:

Run Start

QC:

Date:

SPC (Y/N):

Date:

Stop

Sequence ID/  
Work Center ID

Operation  
Description

Set Up/  
Run Hours

Draw  
Number

Draw  
Rev.

Plan  
Code

Accept  
Qty

Reject  
Qty

Reject  
Number

Insp.  
Stamp

220

QC5- Inspect part completeness to step on W/O

0.00



QC

Memo

0.00

Quality Control

81267102

230

HandFinishing

0.00



HandFinish

Memo

0.00

Hand Finishing

Install Inserts as per Dwg

=> M 16/07/07

X1

240

QC5- Inspect part completeness to step on W/O

0.00



QC

Memo

0.00

Quality Control

81267102

⊕

# Work Order ID 56491

February 25, 2010 7:32:59 AM

Page 8

Item ID: D3391-023

Revision ID:

Item Name: Mid Tube Assembly

Start Date: 2/25/10 Start Qty: 1.00

Required Date: 3/05/10 Req'd Qty: 1.00

Reference:

Approvals: Process Plan:

Date:

Tooling:

Date:

Run Start

QC:

Date:

SPC (Y/N):

Date:

Stop

Sequence ID/  
Work Center ID

Operation  
Description

Set Up/  
Run Hours

Draw  
Number

Draw  
Rev.

Plan  
Code

Accept  
Qty

Reject  
Qty

Reject  
Number

Insp.  
Stamp

250

Identify as per dwg & Stock Location: \_\_\_\_\_

0.00

0.00

Packaging

Packaging

used on

W/ 56382  
Memo

2794

10/07/07

①

Ø

D412-742-043

260

QC21- Final Inspection - Work Order Release

0.00

0.00

QC

Quality Control

Memo



1007-08

mf 10-7-8

# Picklist Print

February 25, 2010 7:32:42 AM

Page 1/3

Work Order ID: 56491

Parent Item: D3391-023

Parent Item Name: Mid Tube Assembly

Comments: IPP A 05.10.20 New Issue KJ/EC  
 IPP B 06.02.10 ECN773 dwg rev.D EC  
 IPP C 07.03.20 rev F dwg EC  
 IPP D 07.03.28 re-format EC

Start Date: 2/25/10

Required Date: 3/05/10

Start Qty: 1.00

Required Qty: 1.00

D2500-1-1000



Skidtube Extrusion

Manufactured No 100 Each 137.0000 1.0000



Warehouse Loc Qty Loc Code  
Location

Main Warehouse

If 87

50251 87

Main Warehouse

ST 50

37065 50

D3391-021



Fwd Tube Assembly

D3389-1



Web

Manufactured No 100 Each 0.0000 1.0000

B 56214



Manufactured No 140 Each 1.0000 1.0000

B 56214



Warehouse Loc Qty Loc Code  
Location

Main Warehouse

ST 1

48244 1

B 56510

①

BE 10/03/02

1 M 10/2/25

1 M 10/3/1

1 M 10/3/1

| W/O: |      | WORK ORDER CHANGES |    |      |     |                                     |                          |
|------|------|--------------------|----|------|-----|-------------------------------------|--------------------------|
| DATE | STEP | PROCEDURE CHANGE   | By | Date | Qty | Approval<br>Chief Eng /<br>Prod Mgr | Approval<br>QC Inspector |
|      |      |                    |    |      |     |                                     |                          |
|      |      |                    |    |      |     |                                     |                          |

Part No: \_\_\_\_\_ PAR #: \_\_\_\_\_ Fault Category: \_\_\_\_\_ NCR: Yes No DQA: \_\_\_\_\_ Date: \_\_\_\_\_

Resolution: \_\_\_\_\_ Disposition: \_\_\_\_\_ QA: N/C Closed: \_\_\_\_\_ Date: \_\_\_\_\_

| NCR: |      | WORK ORDER NON-CONFORMANCE (NCR) |                             |                                 |                |                           |                       |                          |
|------|------|----------------------------------|-----------------------------|---------------------------------|----------------|---------------------------|-----------------------|--------------------------|
| DATE | STEP | Description of NC<br>Section A   | Corrective Action Section B |                                 |                | Verification<br>Section C | Approval<br>Chief Eng | Approval<br>QC Inspector |
|      |      |                                  | Initial<br>Chief Eng        | Action Description<br>Chief Eng | Sign &<br>Date |                           |                       |                          |
|      |      |                                  |                             |                                 |                |                           |                       |                          |
**NOTE:** Date & initial all entries

# Picklist Print

February 25, 2010 7:32:42 AM

Page 2 / 3

Work Order ID: 56491

Parent Item: D3391-023

Parent Item Name: Mid Tube Assembly

Comments: IPP A 05.10.20 New Issue! KJ/EC  
 IPP B 06.02.10 ECN773 dwg rev.D EC..  
 IPP C 07.03.20 rev F dwg EC  
 IPP D 07.03.28 re-format EC

Start Date: 2/25/10

Required Date: 3/05/10

Start Qty: 1.00

Required Qty: 1.00



Manufactured No 160 Each 39.0000 5.0000

Warehouse Loc Qty Loc Code  
Location

Main Warehouse

LG 37

51920 20

52898 17

Main Warehouse

ST 2

47123 2

E5 BE 10/03/03



Manufactured No 210 Each 37.0000 2.0000

Warehouse Loc Qty Loc Code  
Location

Main Warehouse

ST 37

46105 29

47121 8

1357350

x2 w 10/07/07

February 25, 2010 7:32:42 AM

Shop Packet Print

Page 2

| W/O: |      | WORK ORDER CHANGES |    |      |     |                                     |                          |  |
|------|------|--------------------|----|------|-----|-------------------------------------|--------------------------|--|
| DATE | STEP | PROCEDURE CHANGE   | By | Date | Qty | Approval<br>Chief Eng /<br>Prod Mgr | Approval<br>QC Inspector |  |
|      |      |                    |    |      |     |                                     |                          |  |
|      |      |                    |    |      |     |                                     |                          |  |

Part No: \_\_\_\_\_ PAR #: \_\_\_\_\_ Fault Category: \_\_\_\_\_ NCR: Yes No DQA: \_\_\_\_\_ Date: \_\_\_\_\_

Resolution: \_\_\_\_\_ Disposition: \_\_\_\_\_ QA: N/C Closed: \_\_\_\_\_ Date: \_\_\_\_\_

| NCR: |      | WORK ORDER NON-CONFORMANCE (NCR) |                             |                                 |                |                           |                       |                          |
|------|------|----------------------------------|-----------------------------|---------------------------------|----------------|---------------------------|-----------------------|--------------------------|
| DATE | STEP | Description of NC<br>Section A   | Corrective Action Section B |                                 |                | Verification<br>Section C | Approval<br>Chief Eng | Approval<br>QC Inspector |
|      |      |                                  | Initial<br>Chief Eng        | Action Description<br>Chief Eng | Sign &<br>Date |                           |                       |                          |
|      |      |                                  |                             |                                 |                |                           |                       |                          |
**NOTE:** Date & initial all entries

# Picklist Print

February 25, 2010 7:32:42 AM

Page 3 13

Work Order ID: 56491



Parent Item: D3391-023



Parent Item Name: Mid Tube Assembly

Start Date: 2/25/10

Required Date: 3/05/10

Comments: IPP A 05.10.20 New Issue  
IPP B 06.02.10 ECN773 dwg rev.D  
IPP C 07.03.20 rev F dwg  
IPP D 07.03.28 re-format

KJ/ECN  
ECN  
EC  
EC

Start Qty: 1.00

Required Qty: 1.00

ALS4-1032-130

Purchased

No

230

Each

1,678.000 22.0000



Insert

Warehouse

Loc Qty

Loc Code

Location

Main Warehouse

ST

1678

110511

1678

M 114723

122 M 16107107




| W/O: |      | WORK ORDER CHANGES |    |      |     |                                     |                          |  |
|------|------|--------------------|----|------|-----|-------------------------------------|--------------------------|--|
| DATE | STEP | PROCEDURE CHANGE   | By | Date | Qty | Approval<br>Chief Eng /<br>Prod Mgr | Approval<br>QC Inspector |  |
|      |      |                    |    |      |     |                                     |                          |  |
|      |      |                    |    |      |     |                                     |                          |  |

Part No: \_\_\_\_\_ PAR #: \_\_\_\_\_ Fault Category: \_\_\_\_\_ NCR: Yes No DQA: \_\_\_\_\_ Date: \_\_\_\_\_

Resolution: \_\_\_\_\_ Disposition: \_\_\_\_\_ QA: N/C Closed: \_\_\_\_\_ Date: \_\_\_\_\_

| NCR: |      | WORK ORDER NON-CONFORMANCE (NCR) |                             |                                 |                |                           |                       |                          |
|------|------|----------------------------------|-----------------------------|---------------------------------|----------------|---------------------------|-----------------------|--------------------------|
| DATE | STEP | Description of NC<br>Section A   | Corrective Action Section B |                                 |                | Verification<br>Section C | Approval<br>Chief Eng | Approval<br>QC Inspector |
|      |      |                                  | Initial<br>Chief Eng        | Action Description<br>Chief Eng | Sign &<br>Date |                           |                       |                          |
|      |      |                                  |                             |                                 |                |                           |                       |                          |
**NOTE:** Date & initial all entries

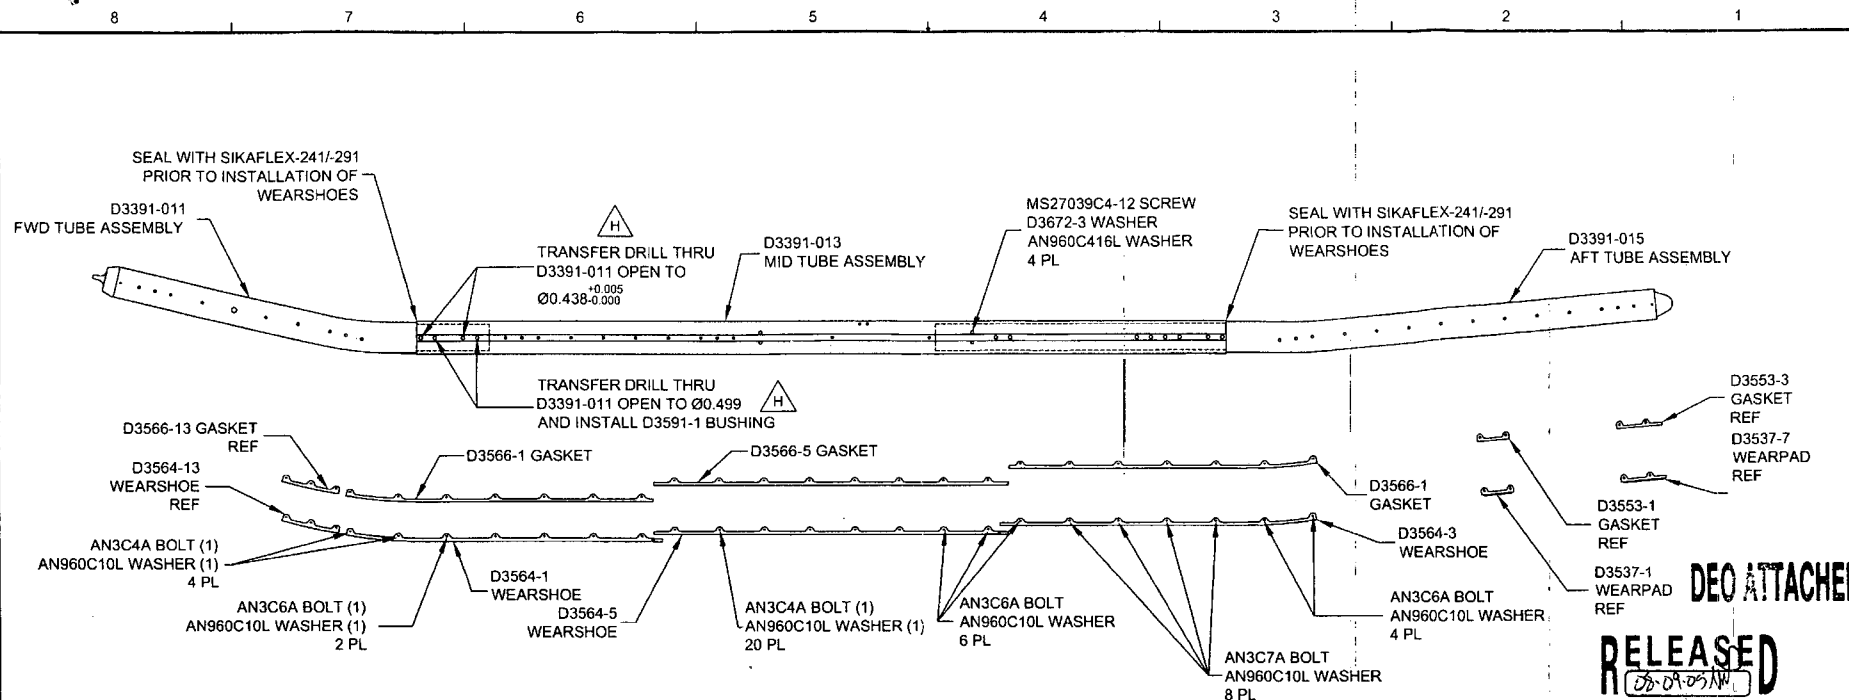

**D3391-041 ASSEMBLY**


**D3391-041 FLOAT SKIDTUBE ASSEMBLY PARTS LIST**

| QTY | PART NUMBER  | DESCRIPTION             |
|-----|--------------|-------------------------|
| X   | D3391-041    | FLOAT SKIDTUBE ASSEMBLY |
| 1   | D3391-011    | FWD TUBE ASSEMBLY       |
| 1   | D3391-013    | MID TUBE ASSEMBLY       |
| 1   | D3391-015    | AFT TUBE ASSEMBLY       |
| 1   | D3564-1      | WEARSHOE                |
| 1   | D3564-3      | WEARSHOE                |
| 1   | D3564-5      | WEARSHOE                |
| 2   | D3566-1      | GASKET                  |
| 2   | D3566-5      | GASKET                  |
| 2   | D3566-13     | GASKET                  |
| 4   | D3672-3      | WASHER                  |
| 24  | AN3C4A       | BOLT                    |
| 12  | AN3C6A       | BOLT                    |
| 8   | AN3C7A       | BOLT                    |
| 44  | AN960C10L    | WASHER                  |
| 4   | MS27039C4-12 | SCREW                   |
| 4   | AN960C416L   | WASHER                  |

**GENERAL NOTES**

- 1) FINISH: CHEMICAL CONVERSION COAT PER DART QSI 005 4.1  
POWDER COAT WHITE (4.3.5.1) PER DART QSI 005 4.3
- 2) SPRAY INSIDE OF TUBE WITH A COAT OF LPS LABORATORIES "LPS-3" AFTER FINISH AND AFTER INSTALLATION OF INSERTS. COAT ALL EXPOSED FASTENERS WITH LPS LABORATORIES "LPS PROCYON" AFTER FINAL ASSEMBLY, CLEAN EXCESS OFF POWDER COATING WITH MEK DEGREASER.
- 3) TOLERANCES: PER DART QSI 018 UNLESS OTHERWISE NOTED
- 4) UNITS: INCHES UNLESS OTHERWISE NOTED
- 5) USE DART DRILL TEMPLATE DT8217 TO LOCATE AND DRILL Ø0.297 SIZE HOLES FOR WEARSHOE INSERTS. C'BORE AS NOTED AND INSTALL INSERTS EXCEPT WHERE INDICATED.

|            |   |   |              |
|------------|---|---|--------------|
| H          | DRAWING UPDATED TO CURRENT STANDARDS.<br>SHT 1 PL ADDED D3591-1 BUSHING. ZN C6 Ø0.438 DIM WAS 4 PL. ADDED Ø0.499 DIM AND D3591-1 BUSHING. SHT 2 PL ADDED D3591-1 BUSHING. ZN C6 Ø0.438 DIM WAS 4 PL. ADDED Ø0.499 DIM AND D3591-1 BUSHING. (FOR FURTHER INFO SEE DSI 9364 & NCR 08-074) | AJS   | 08.08.20     |
| G          | REPLACE NAS INSERTS W/ AELS INSERTS<br>SWITCH TO D3670-XXXX SPACERS FOR INSTALLING<br>FLOAT BAGS, DWG REORGANIZED FOR CLARITY   | DC  | 07.07.31     |
| F          | ADD SS WEARSHOE, GASKET<br>REMOVE FWD SADDLE HOLE -011/-021   | PH  | 07.01.18     |
| E          | CHANGE TOLERANCE, EASE MANUFACTURE  | PH  | 06.04.25     |
| D          | UPDATE TOLERANCE, CHANGE HOLE SIZE  | PH  | 06.01.23     |
| C          | LENGTHEN AFT EXTENSION  | PH  | 05.09.27     |
| B          | DRAWING UPDATES   | PH  | 05.06.10     |
| A          | NEW ISSUE   | PH  | 05.02.07     |
| REV        | DESCRIPTION   | BY  | DATE         |
| DESIGN     | PH  | <b>DART AEROSPACE USA, INC</b>  |              |
| DRAWN      | A/S   | PORT HADLOCK, WA  |              |
| CHECKED    |   | DRAWING NO.   | REV. H       |
| MFG. APPR. |   | D3391   | SHEET 1 OF 8 |
| APPROVED   |   | TITLE   | SCALE        |
| DE APPR.   |   | 412 FLOAT SKIDTUBE  | NTS          |
| DATE       | 08.08.20  | COPYRIGHT © 2005 BY DART AEROSPACE USA, INC<br>THIS DOCUMENT IS PRIVATE AND CONFIDENTIAL, AND IS SUPPLIED ON THE EXPRESS CONDITION THAT IT IS<br>NOT TO BE USED FOR ANY PURPOSE OR COME OR COMMUNICATED TO ANY OTHER PERSON WITHOUT<br>WRITTEN PERMISSION FROM DART AEROSPACE USA, INC. |              |

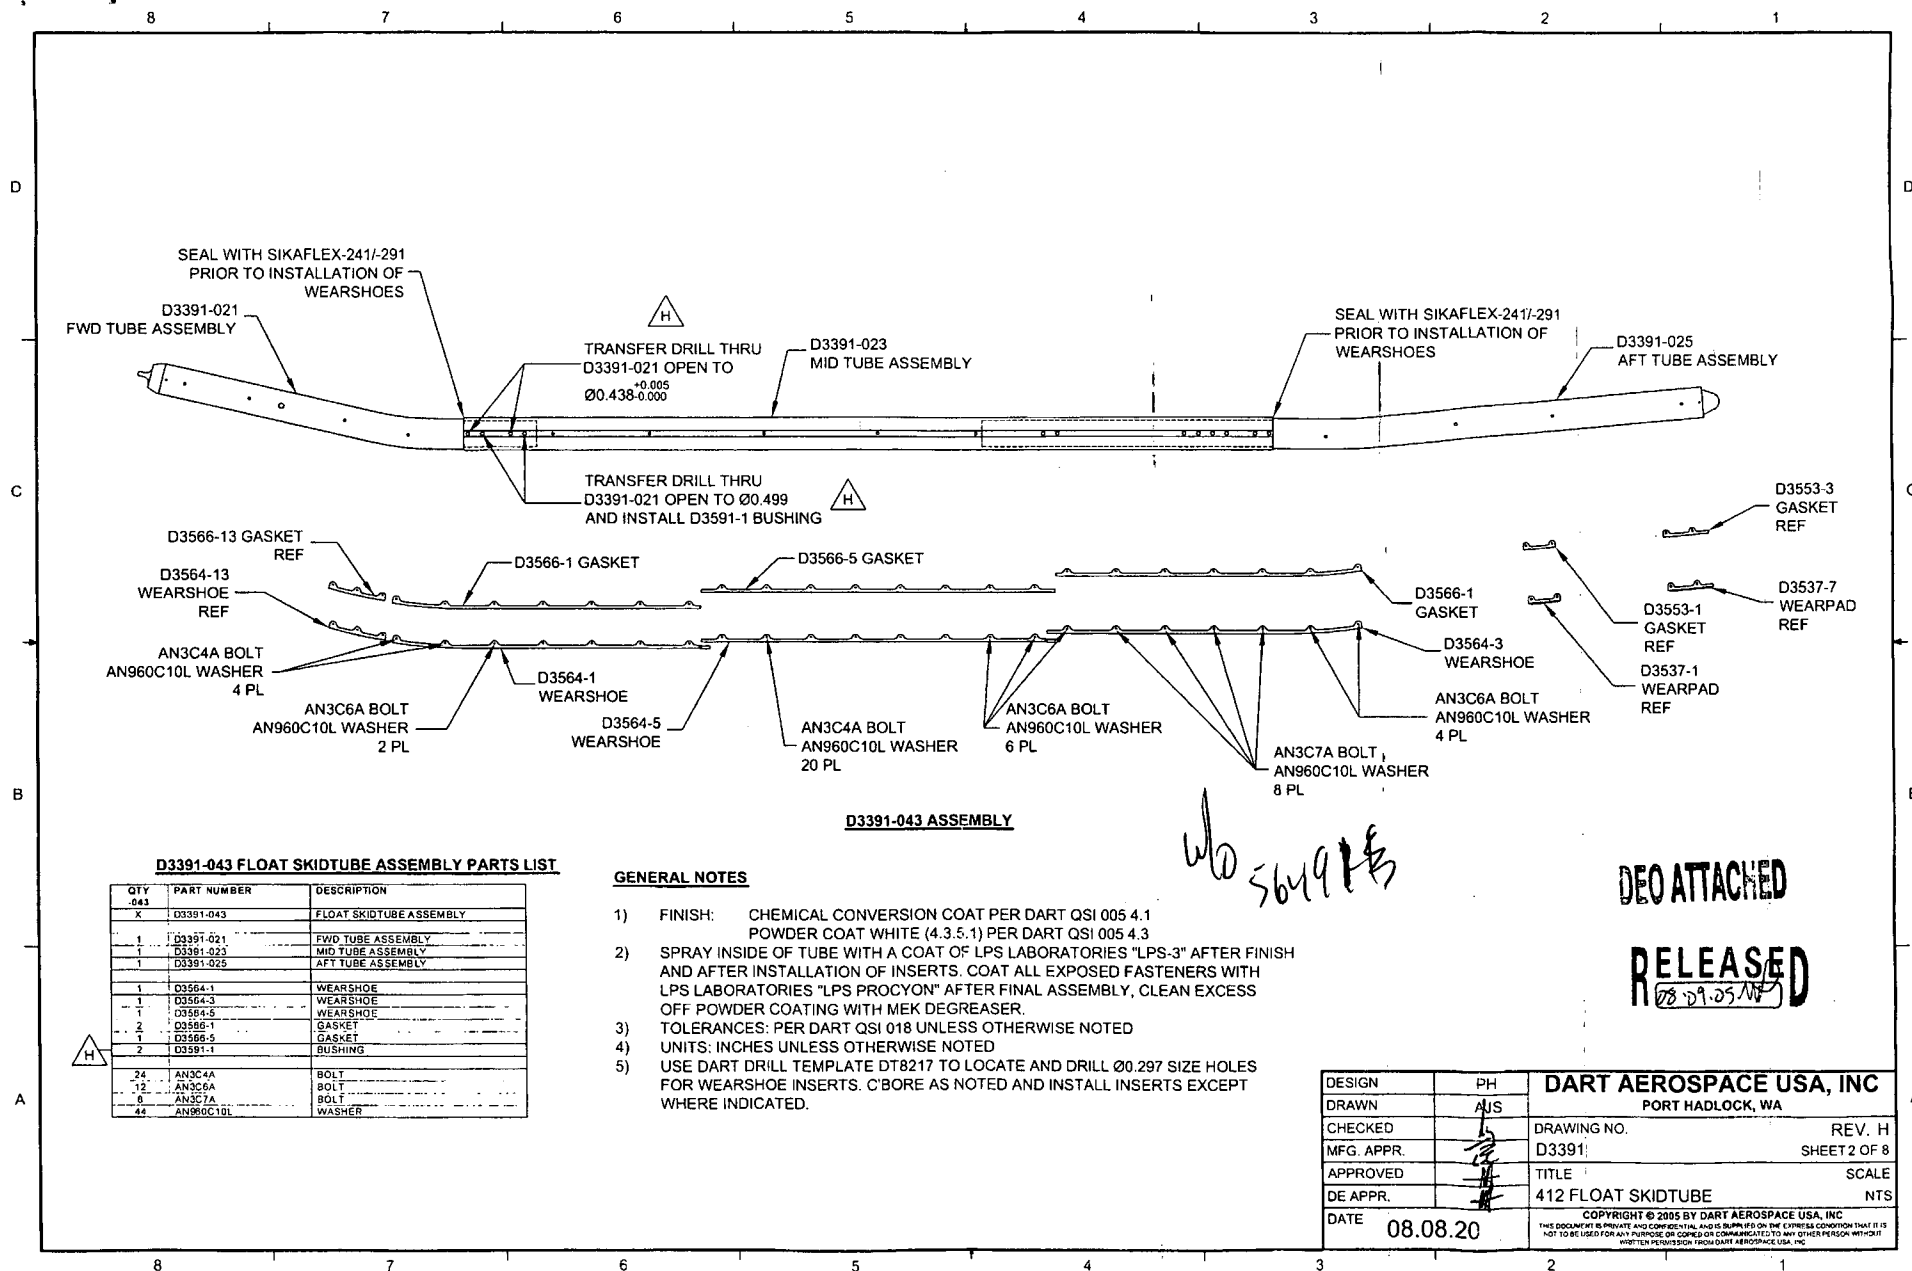

**D3391-043 FLOAT SKIDTUBE ASSEMBLY PARTS LIST**

| QTY | PART NUMBER | DESCRIPTION             |
|-----|-------------|-------------------------|
| X   | D3391-043   | FLOAT SKIDTUBE ASSEMBLY |
| 1   | D3391-021   | FWD TUBE ASSEMBLY       |
| 1   | D3391-023   | MID TUBE ASSEMBLY       |
| 1   | D3391-025   | AFT TUBE ASSEMBLY       |
| 1   | D3564-1     | WEARSHOE                |
| 1   | D3564-3     | WEARSHOE                |
| 1   | D3564-5     | WEARSHOE                |
| 1   | D3566-1     | GASKET                  |
| 2   | D3566-5     | GASKET                  |
| 2   | D3591-1     | BUSHING                 |
| 24  | AN3C4A      | BOLT                    |
| 12  | AN3C6A      | BOLT                    |
| 0   | AN3C7A      | BOLT                    |
| 44  | AN960C10L   | WASHER                  |


**GENERAL NOTES**

- 1) FINISH: CHEMICAL CONVERSION COAT PER DART QSI 005 4.1  
POWDER COAT WHITE (4.3.5.1) PER DART QSI 005 4.3
- 2) SPRAY INSIDE OF TUBE WITH A COAT OF LPS LABORATORIES "LPS-3" AFTER FINISH AND AFTER INSTALLATION OF INSERTS. COAT ALL EXPOSED FASTENERS WITH LPS LABORATORIES "LPS PROCYON" AFTER FINAL ASSEMBLY, CLEAN EXCESS OFF POWDER COATING WITH MEK DEGREASER.
- 3) TOLERANCES: PER DART QSI 018 UNLESS OTHERWISE NOTED
- 4) UNITS: INCHES UNLESS OTHERWISE NOTED
- 5) USE DART DRILL TEMPLATE DT8217 TO LOCATE AND DRILL Ø0.297 SIZE HOLES FOR WEARSHOE INSERTS. C'BORE AS NOTED AND INSTALL INSERTS EXCEPT WHERE INDICATED.


|            |          |  |              |
|------------|----------|--|--------------|
| DESIGN     | PH       | <b>DART AEROSPACE USA, INC</b>   |              |
| DRAWN      | AUS      | PORT HADLOCK, WA   |              |
| CHECKED    |          | DRAWING NO.  | REV. H       |
| MFG. APPR. |          | D3391  | SHEET 2 OF 8 |
| APPROVED   |          | TITLE  | SCALE        |
| DE APPR.   |          | 412 FLOAT SKIDTUBE   | NTS          |
| DATE       | 08.08.20 | <small>COPYRIGHT © 2005 BY DART AEROSPACE USA, INC.<br/>THIS DOCUMENT IS PRIVATE AND CONFIDENTIAL AND IS SUPPLIED ON THE EXPRESS CONDITION THAT IT IS NOT TO BE USED FOR ANY PURPOSE OR COPIED OR COMMUNICATED TO ANY OTHER PERSON WITHOUT WRITTEN PERMISSION THROUGH DART AEROSPACE USA, INC.</small> |              |

DEO ATTACHED


RELEASED  
08.09.25

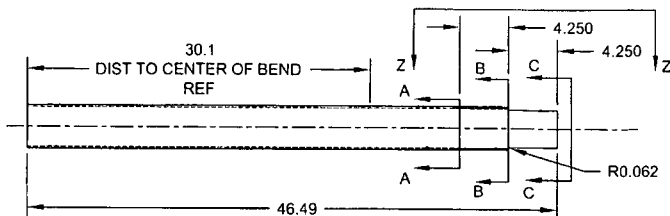


**D3391-1 CUTTING DETAIL**  
(MAKE FROM D6013-047 SKIDTUBE MATERIAL)

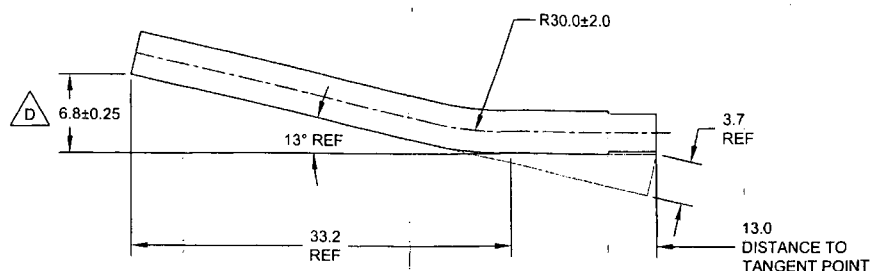


**D3391-011/-021 BENDING DETAIL**  
(MAKE FROM D3391-1)

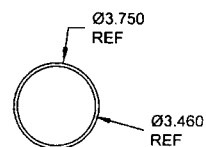


**SECTION A-A**  
SCALE 2X

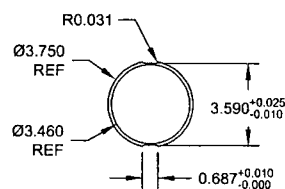

**SECTION B-B**  
SCALE 2X

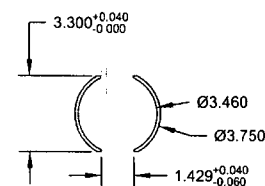

**SECTION C-C**  
SCALE 2X

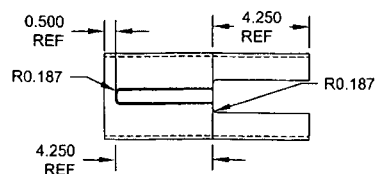


**VIEW Z-Z**  
SCALE 2X

*W6 56491*


**DEO ATTACHED**  
**RELEASED**  
*8-21-05 NW*

|            |                    |  |        |
|------------|--------------------|--|--------|
| DESIGN     | PH                 | <b>DART AEROSPACE USA, INC</b>   |        |
| DRAWN      | AJS                | PORT HADLOCK, WA   |        |
| CHECKED    | <i>[Signature]</i> | DRAWING NO. D3391  | REV. H |
| MFG. APPR. | <i>[Signature]</i> | SHEET 3 OF 8   |        |
| APPROVED   | <i>[Signature]</i> | TITLE  | SCALE  |
| DE APPR.   | <i>[Signature]</i> | 412 FLOAT SKIDTUBE   | NTS    |
| DATE       | 08.08.20           | <small>COPYRIGHT © 2005 BY DART AEROSPACE USA, INC<br/>THIS DOCUMENT IS PRIVATE AND CONFIDENTIAL AND IS SUPPLIED ON THE EXPRESS CONDITION THAT IT IS NOT TO BE USED FOR ANY PURPOSE OR COPIED OR COMMUNICATED TO ANY OTHER PERSON WITHOUT WRITTEN PERMISSION FROM DART AEROSPACE USA, INC.</small> |        |

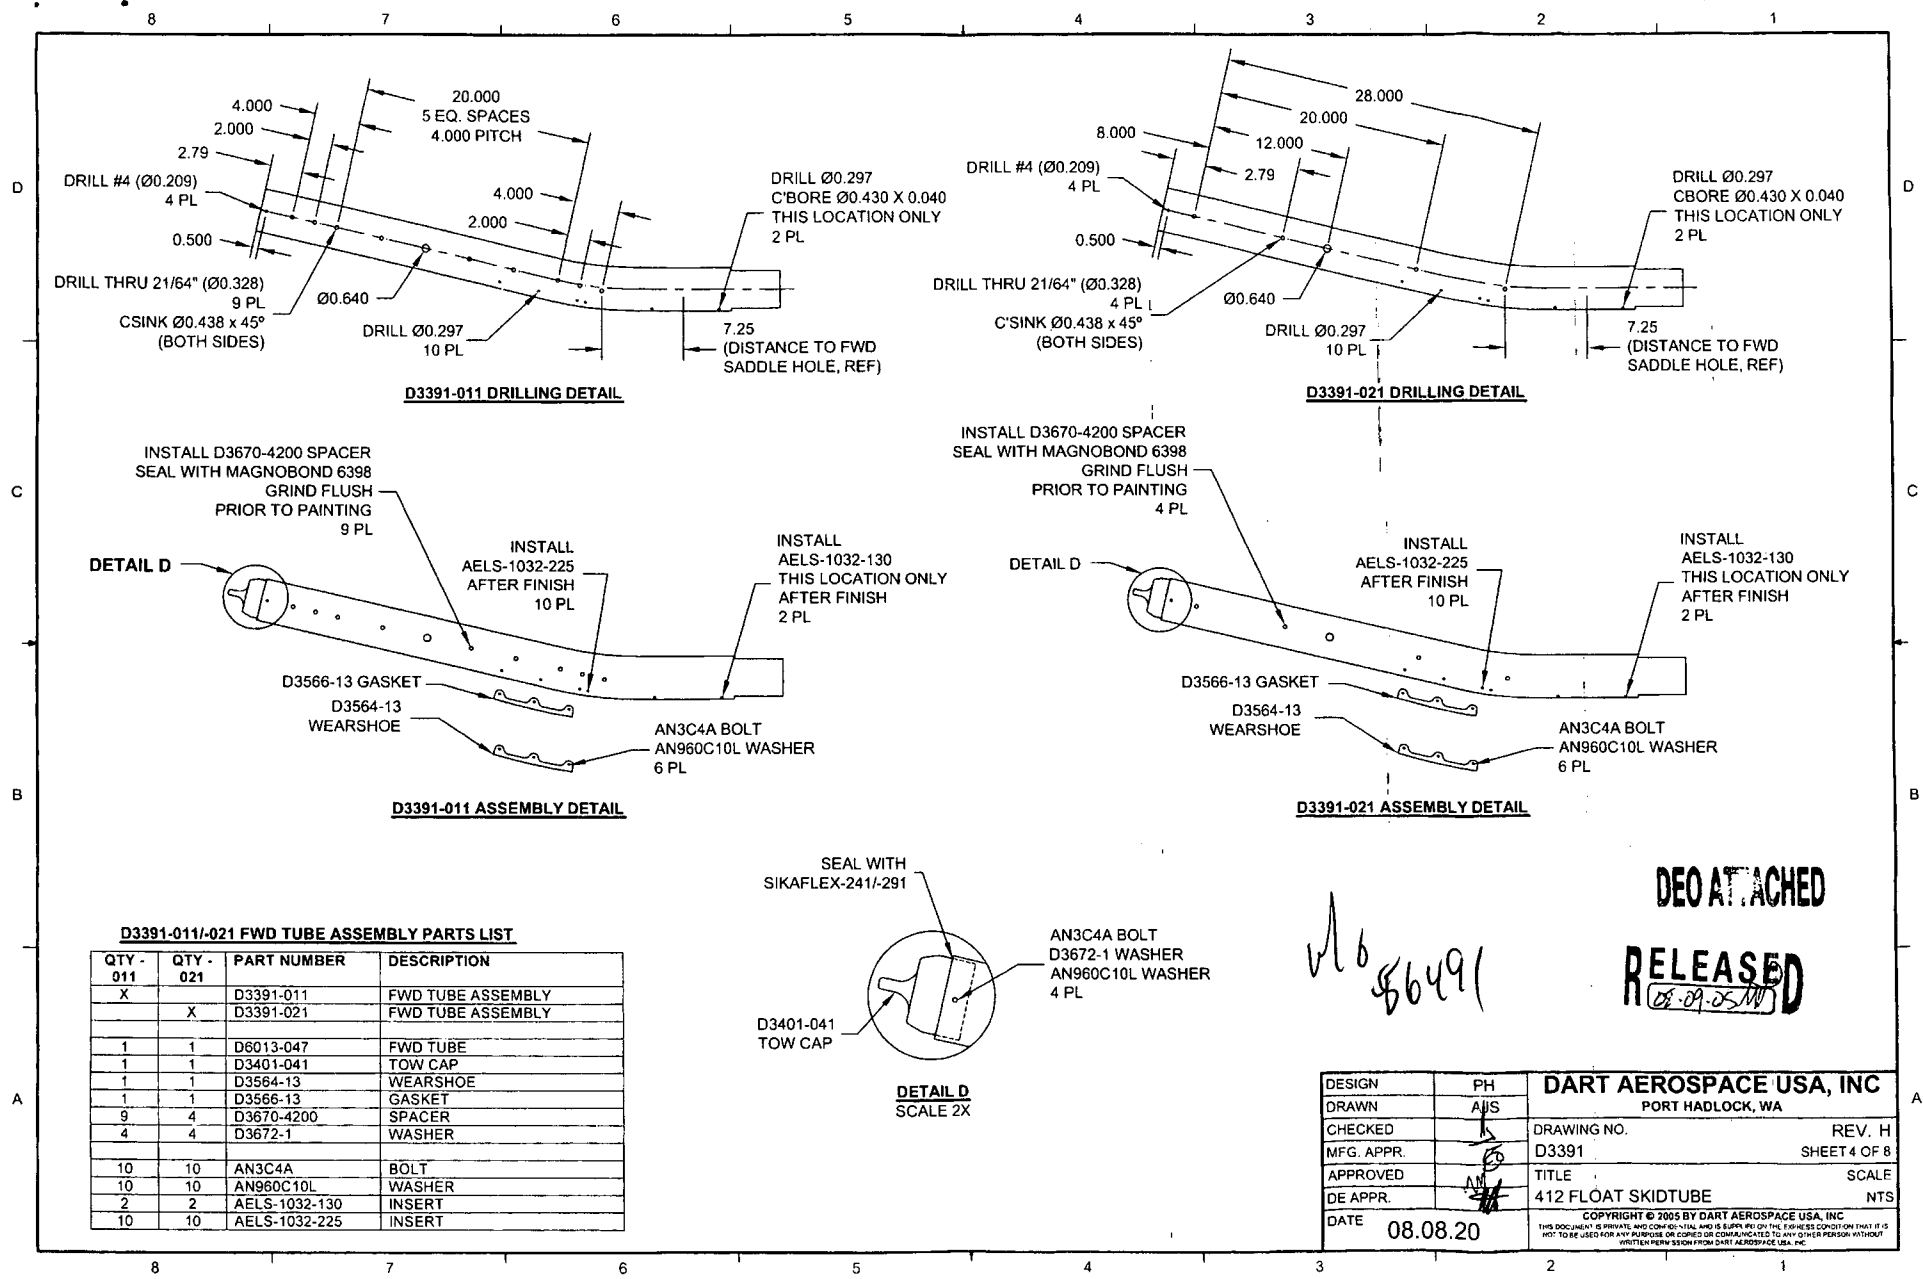

**D3391-011/-021 FWD TUBE ASSEMBLY PARTS LIST**


| QTY - 011 | QTY - 021 | PART NUMBER   | DESCRIPTION       |
|-----------|-----------|---------------|-------------------|
| X         |           | D3391-011     | FWD TUBE ASSEMBLY |
|           | X         | D3391-021     | FWD TUBE ASSEMBLY |
| 1         | 1         | D6013-047     | FWD TUBE          |
| 1         | 1         | D3401-041     | TOW CAP           |
| 1         | 1         | D3564-13      | WEARSHOE          |
| 1         | 1         | D3566-13      | GASKET            |
| 9         | 4         | D3670-4200    | SPACER            |
| 4         | 4         | D3672-1       | WASHER            |
| 10        | 10        | AN3C4A        | BOLT              |
| 10        | 10        | AN960C10L     | WASHER            |
| 2         | 2         | AELS-1032-130 | INSERT            |
| 10        | 10        | AELS-1032-225 | INSERT            |

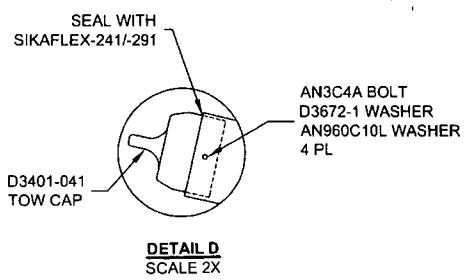


*Handwritten:* 16 86491

**DEO ATTACHED**  
**RELEASED**  
*Handwritten:* 08-09-25 M


|            |          |     |   |              |
|------------|----------|-----|---|--------------|
| DESIGN     |          | PH  | <b>DART AEROSPACE USA, INC</b>  |              |
| DRAWN      |          | AJS | PORT HADLOCK, WA  |              |
| CHECKED    |          |     | DRAWING NO.   | REV. H       |
| MFG. APPR. |          |     | D3391   | SHEET 4 OF 8 |
| APPROVED   |          |     | TITLE   | SCALE        |
| DE APPR.   |          |     | 412 FLOAT SKIDTUBE  | NTS          |
| DATE       | 08.08.20 |     | <small>COPYRIGHT © 2005 BY DART AEROSPACE USA, INC<br/>THIS DOCUMENT IS PRIVATE AND CONFIDENTIAL AND IS SUBJECT TO THE FOLLOWING CONDITION THAT IT IS NOT TO BE USED FOR ANY PURPOSE OR COPIED OR COMMUNICATED TO ANY OTHER PERSON WITHOUT WRITTEN PERMISSION FROM DART AEROSPACE USA, INC.</small> |              |

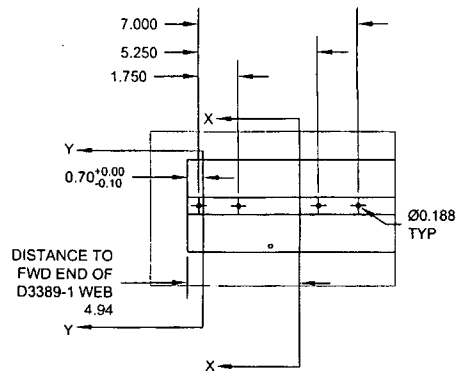

**DETAIL J**  
SCALE 4X

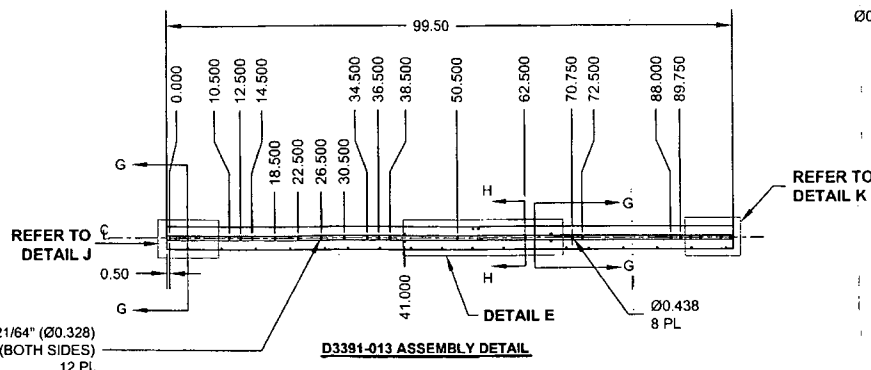


**D3391-013 ASSEMBLY DETAIL**

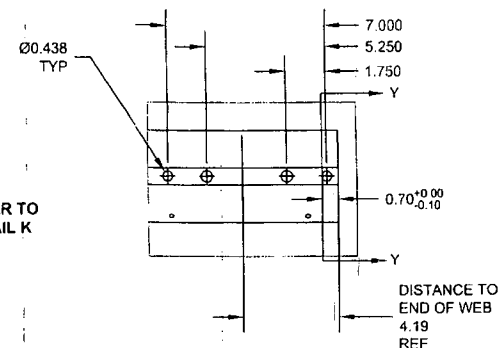


**DETAIL K**  
SCALE 4X




**SECTION G-G**  
SCALE 5X

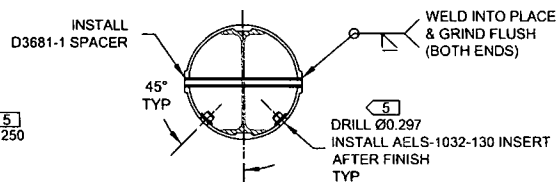

**SECTION H-H**  
SCALE 5X

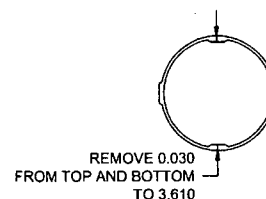


**SECTION X-X**  
SCALE 5X

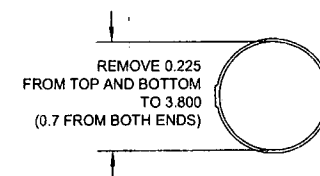


**SECTION Y-Y**  
SCALE 5X

**D3391-013 MID TUBE ASSEMBLY PARTS LIST**


| QTY | PART NUMBER   | DESCRIPTION       |
|-----|---------------|-------------------|
| X   | D3391-013     | MID TUBE ASSEMBLY |
| 1   | D2500-1-100   | EXTRUSION         |
| 1   | D3389-1       | WEB               |
| 4   | D3672-1       | WASHER            |
| 4   | D3672-3       | WASHER            |
| 12  | D3681-1       | SPACER            |
| 24  | AELS-1032-130 | INSERT            |
| 4   | ALS4-428-165  | INSERT            |
| 4   | AN960C10L     | WASHER            |
| 4   | AN960C416L    | WASHER            |
| 4   | MS27039C1-09  | SCREW             |
| 4   | MS27039C4-08  | SCREW             |

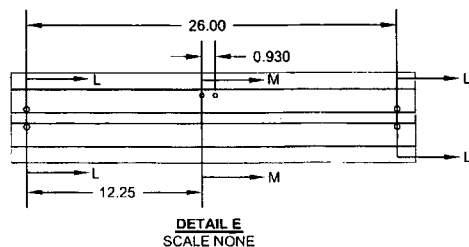


**DETAIL E**  
SCALE NONE

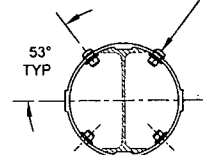

**SECTION M-M**  
SCALE 5X

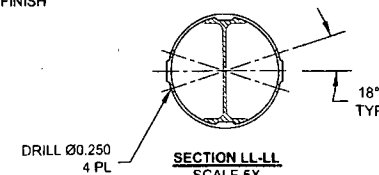

**SECTION LL-LL**  
SCALE 5X

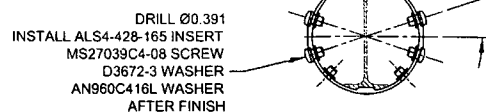

**SECTION L-L**  
SCALE 5X


DEO ATTACHED

RELEASED


**D3391-013 MID TUBE ASSEMBLY**

- MATERIAL: MAKE FROM D2500-1-100 EXTRUSION
- INSTALL D3389-1 WEB TO OUTER TUBE USING SIKAFLEX-2411/291 PER QSI 015
- WELDING: PER DART QSI 004


|            |          |  |              |
|------------|----------|--|--------------|
| DESIGN     | PH       | <b>DART AEROSPACE USA, INC</b>               |              |
| DRAWN      | AJS      | PORT HADLOCK, WA                             |              |
| CHECKED    |          | DRAWING NO.                                  | REV. H       |
| MFG. APPR. |          | D3391  | SHEET 5 OF 8 |
| APPROVED   |          | TITLE  | SCALE        |
| DE APPR.   |          | 412 FLOAT SKIDTUBE                           | NTS          |
| DATE       | 08.08.20 | COPYRIGHT © 2005 BY DART AEROSPACE USA, INC. |              |

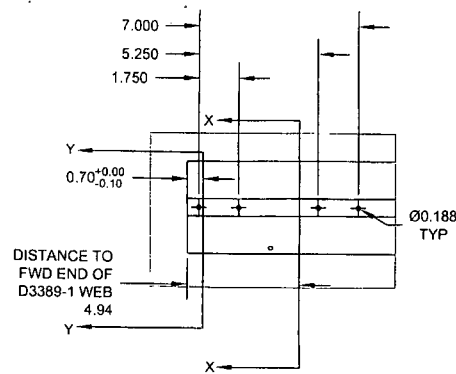

**DETAIL J**  
SCALE 4X

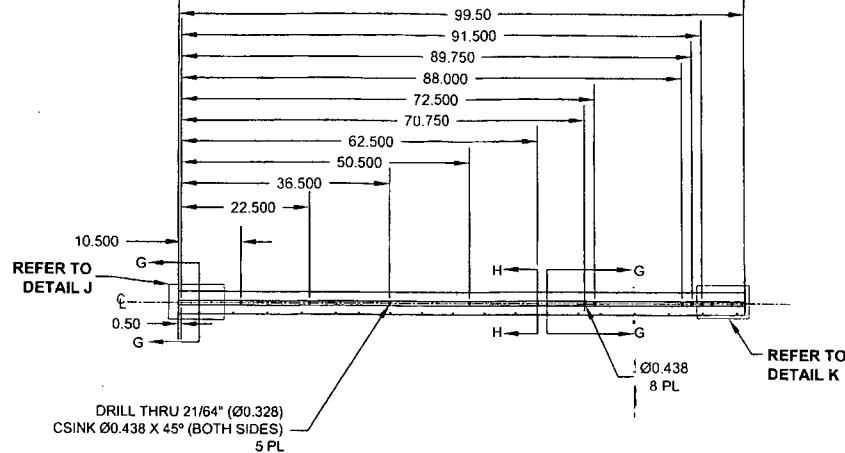


**D3391-023 ASSEMBLY DETAIL**

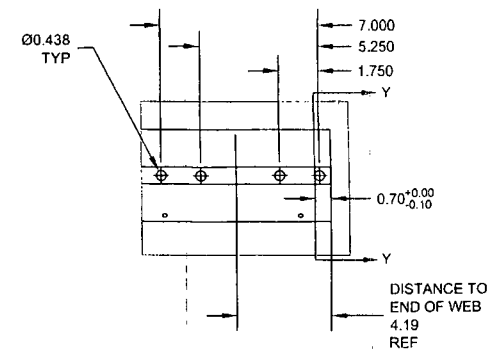


**DETAIL K**  
SCALE 4X



**SECTION G-G**  
SCALE 5X

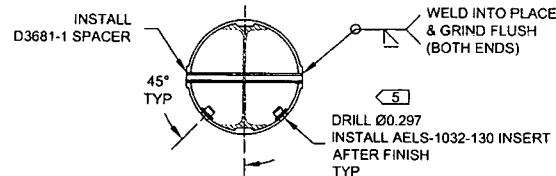

**SECTION H-H**  
SCALE 5X

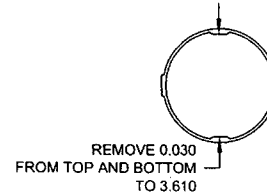

**SECTION X-X**  
SCALE 5X

REMOVE 0.225  
FROM TOP AND BOTTOM  
TO 3.800  
(0.7 FROM BOTH ENDS)

**SECTION Y-Y**  
SCALE 5X

**D3391-023 MID TUBE ASSEMBLY PARTS LIST**

| QTY - 023 | PART NUMBER   | DESCRIPTION       |
|-----------|---------------|-------------------|
| X         | D3391-023     | MID TUBE ASSEMBLY |
| 1         | D2500-1-100   | EXTRUSION         |
| 1         | D3389-1       | WEB               |
| 5         | D3681-1       | SPACER            |
| 20        | AELS-1032-130 | INSERT            |


**D3391-023 MID TUBE ASSEMBLY**

- 1) MATERIAL: MAKE FROM D2500-1-100 EXTRUSION
- 2) INSTALL D3389-1 WEB TO OUTER TUBE USING SIKAFLEX-2411-291 PER QSI 015
- 3) WELDING: PER DART QSI 004

*WLO 56491*


**DEO ATTACHED**  
**RELEASED**  
*08-09-05-14*

|            |          |   |
|------------|----------|---|
| DESIGN     | PH       | <b>DART AEROSPACE USA, INC</b>              |
| DRAWN      | A/S      | PORT HADLOCK, WA                            |
| CHECKED    |          | DRAWING NO. D3391                           |
| MFG. APPR. |          | REV. H SHEET 6 OF 8                         |
| APPROVED   |          | TITLE SCALE                                 |
| DE APPR.   |          | 412 FLOAT SKIDTUBE NTS                      |
| DATE       | 08.08.20 | COPYRIGHT © 2005 BY DART AEROSPACE USA, INC |

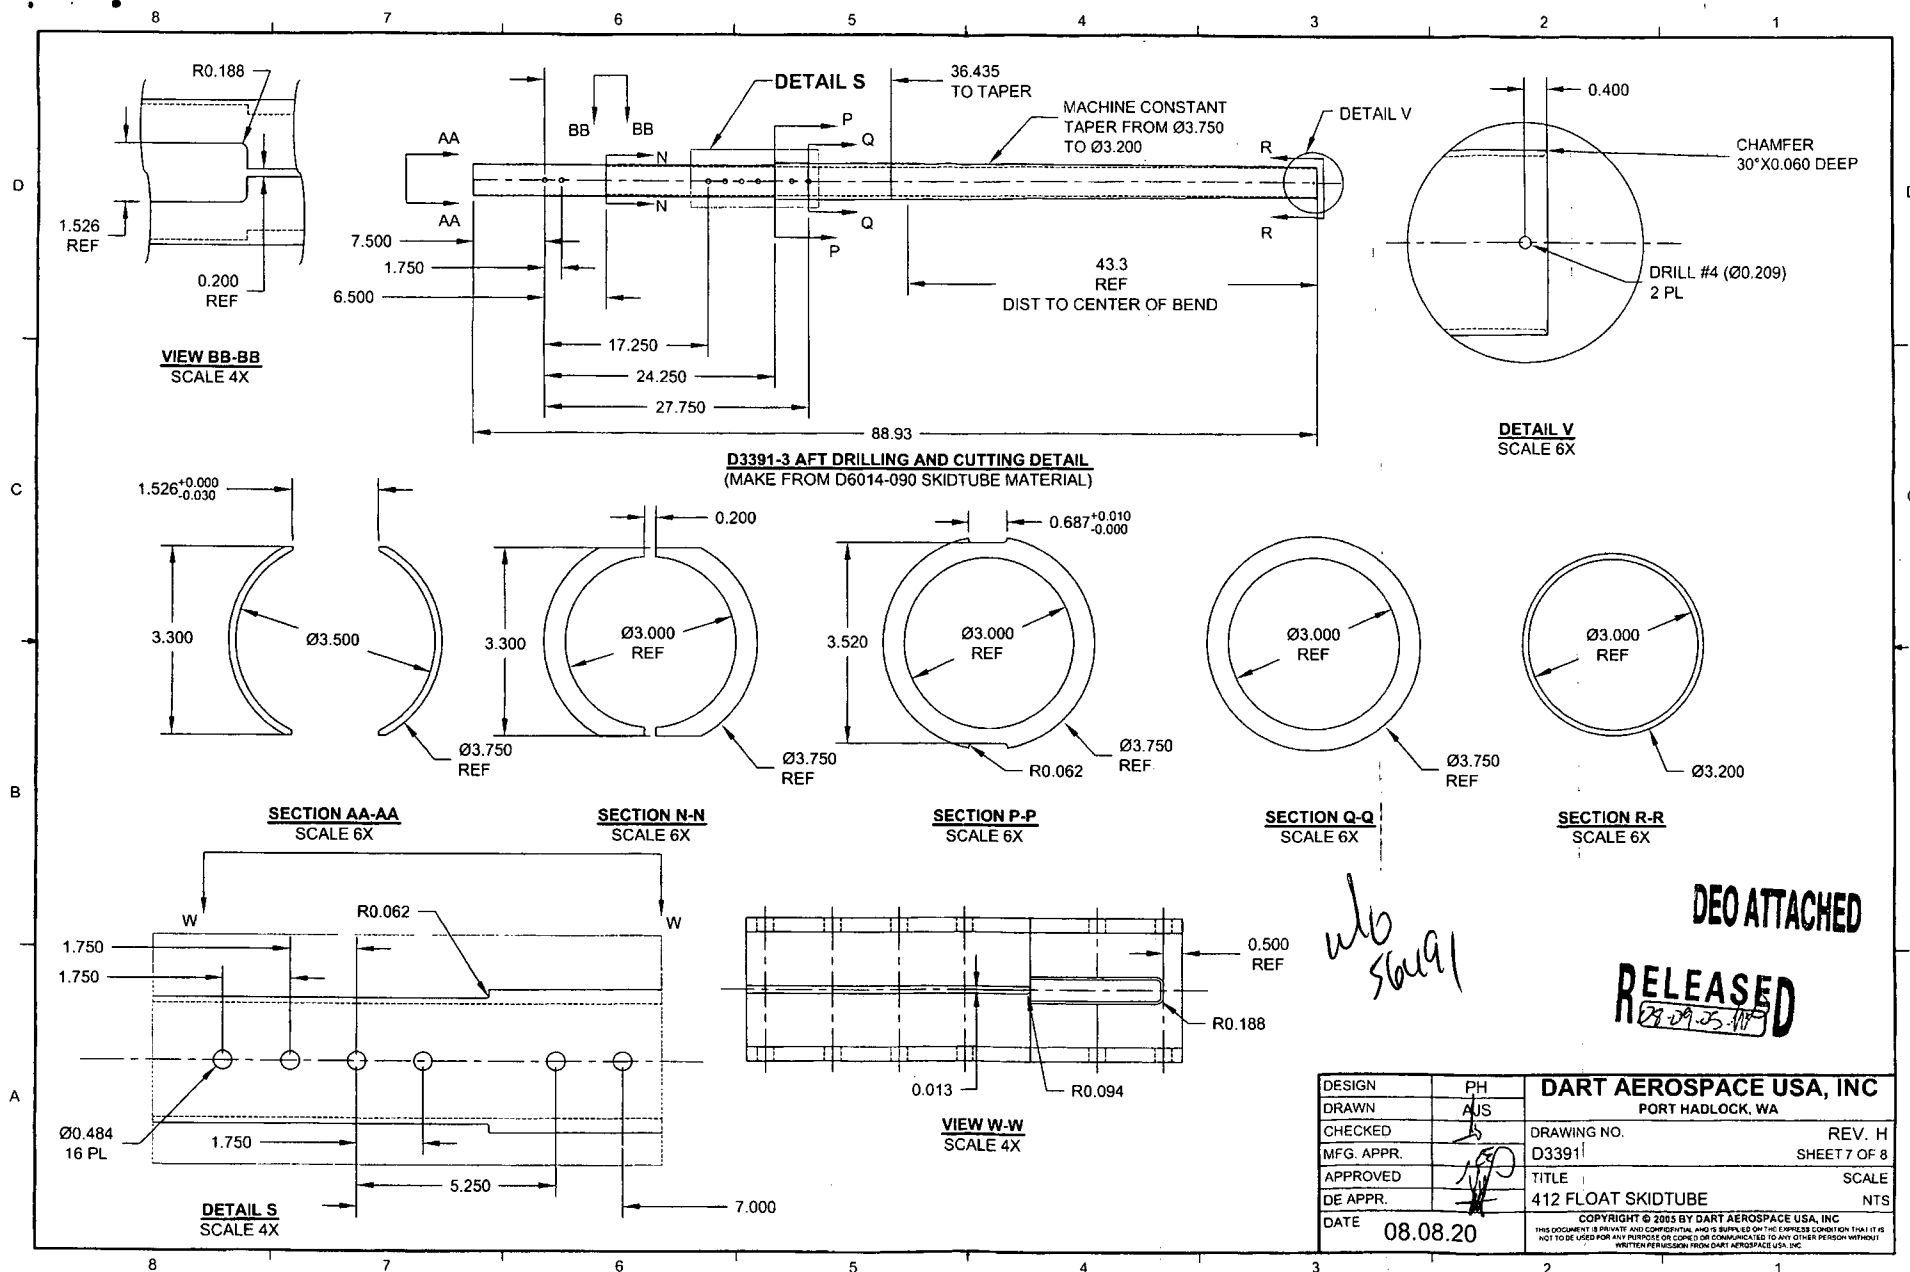

DEO ATTACHED  
RELEASED  
27-09-05-118



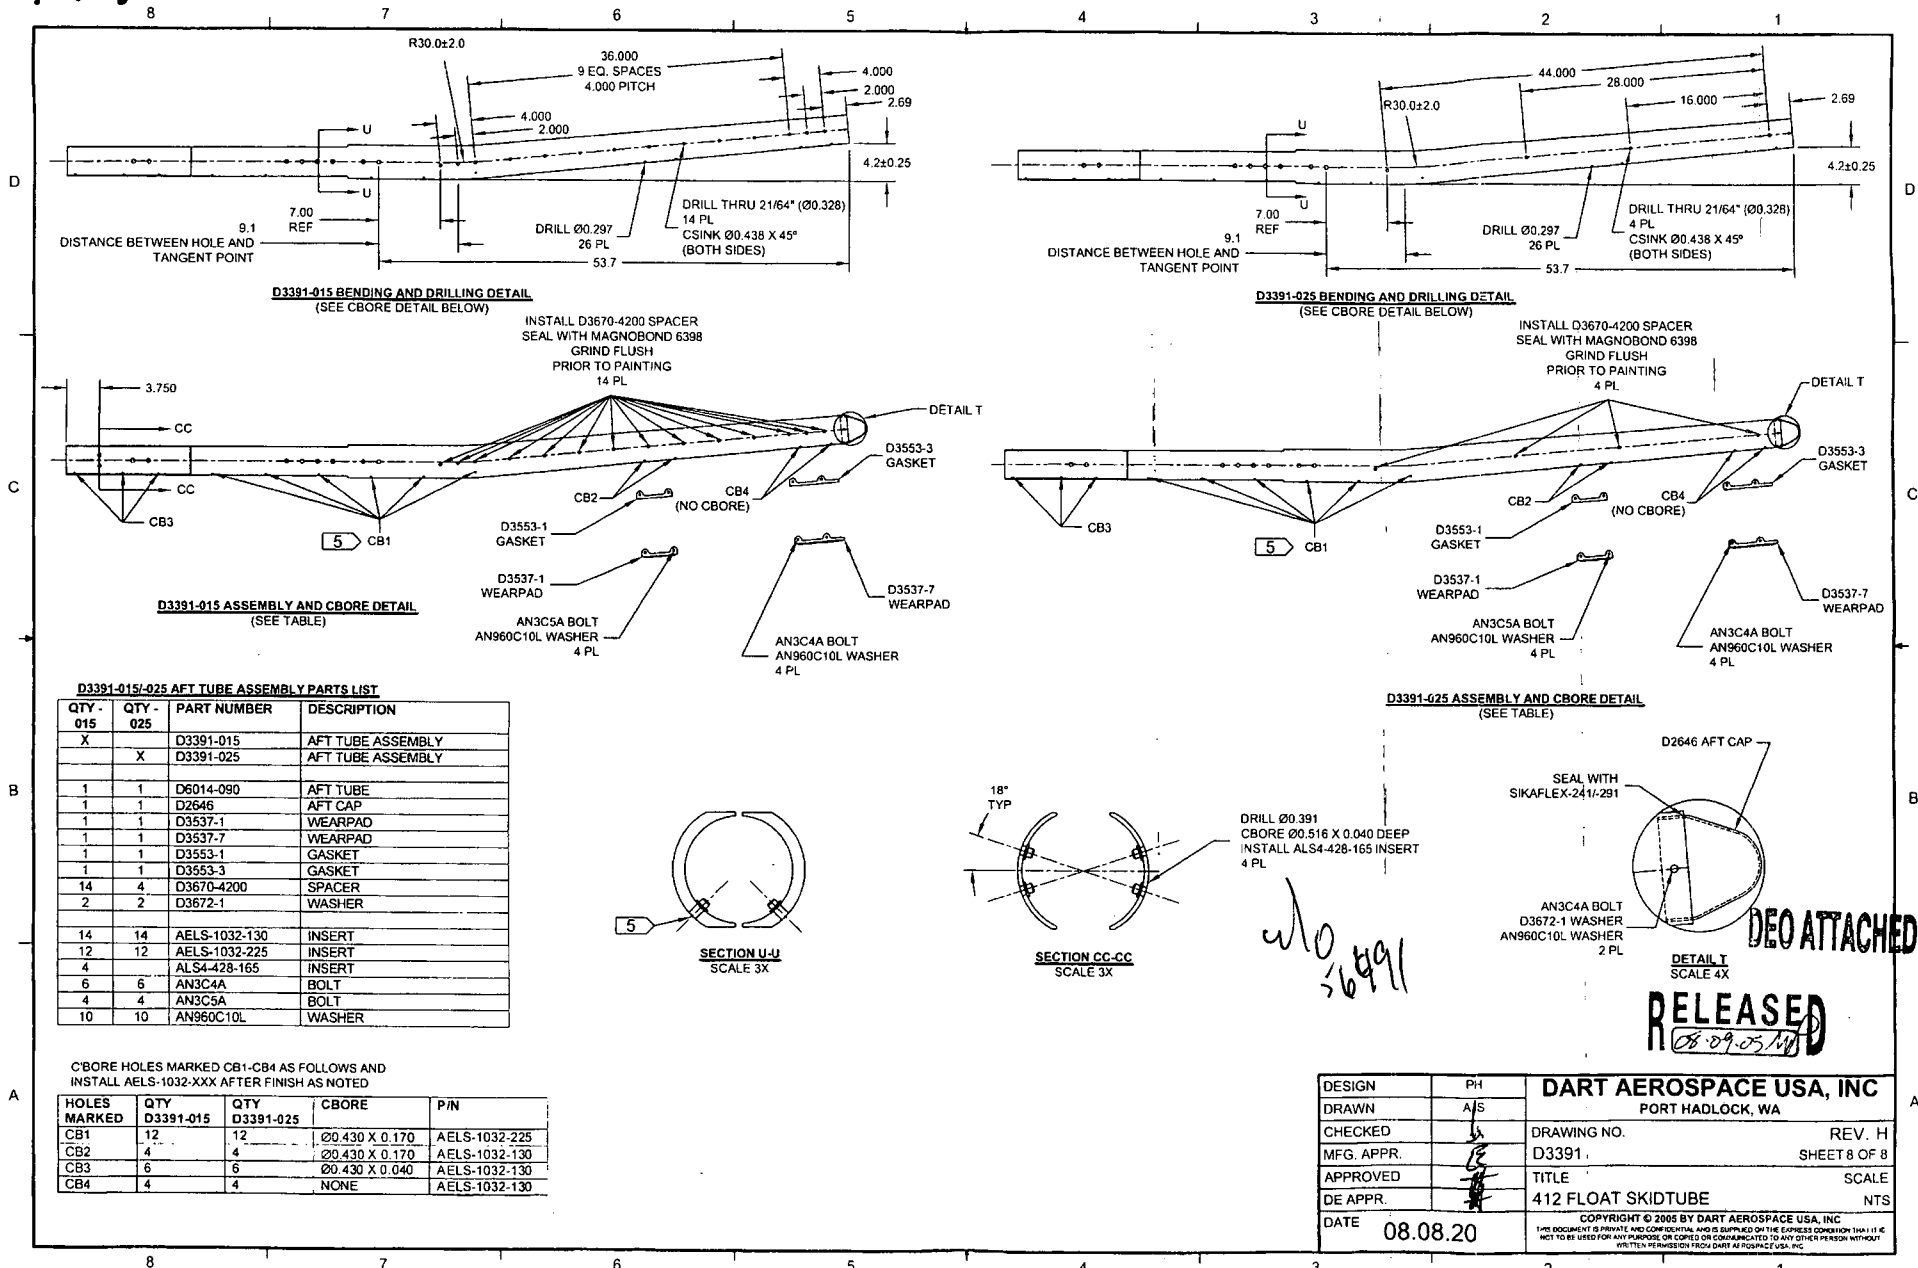

|                      |                             |                     |  |  |                         |                           |              |
|----------------------|-----------------------------|---------------------|--|--|-------------------------|---------------------------|--------------|
| DRAWING NO.<br>D3391 | TITLE<br>412 FLOAT SKIDTUBE | REV. H              | DART AEROSPACE USA, INC<br>ENGINEERING ORDER |  | D.E.O. NO.<br>D3391-H-1 | SHEET NO.<br>SHEET 1 OF 1 | SCALE<br>NTS |
| DRAWN <i>UP</i>      | CHECKED <i>h</i>            | MFG. APPR. <i>W</i> | APPROVED <i>MP</i>                           |  | DE APPR. <i>W</i>       |                           |              |
| DATE 09.09.23        | DATE 04.04.24               | DATE 09/09/25       | DATE 09/09/30                                |  | DATE 09/09/30           |                           |              |

**PURPOSE:**

LPS-3 IS NO LONGER USED DURING ASSEMBLY OF D3391-041/-043 SKIDTUBES.

**CHANGE:**

AMEND NOTE 2 OF D3391-041/-043 SKIDTUBE ASSEMBLIES (ZN A6-1, A6-2) AS FOLLOWS:

- 2) ~~SPRAY INSIDE OF TUBE WITH A COAT OF LPS LABORATORIES "LPS-3" AFTER FINISH~~  
~~AND AFTER INSTALLATION OF INSERTS. COAT ALL EXPOSED FASTENERS WITH~~  
 LPS LABORATORIES "LPS PROCYON" AFTER FINAL ASSEMBLY, CLEAN EXCESS  
 OFF POWDER COATING WITH MEK DEGREASER.

**RELEASED**  
 2010-02-02

*MP*

*wlo 56491*

COPYRIGHT © 2009 BY DART AEROSPACE USA, INC

THIS DOCUMENT IS PRIVATE AND CONFIDENTIAL AND IS SUPPLIED ON THE EXPRESS CONDITION THAT IT IS  
 NOT TO BE USED FOR ANY PURPOSE OR COPIED OR COMMUNICATED TO ANY OTHER PERSON WITHOUT  
 WRITTEN PERMISSION FROM DART AEROSPACE USA, INC.

NO. 224

AWS D17.1.2001  
QUALIFICATION TEST RECORD

Name: Burckley Elliott  
Job number: 53938  
Part number: D3391-023  
Description: Hot Mid tube  
Welding Process: Tig[☒] Mig[ ]  
Base material: Aluminum  
Current: AC[☒] DC[ ]

TEST REQUIREMENTS AND RESULTS

Visual: pass[☒] fail[ ]  
Penetration: pass[☒] fail[ ]

UNACCEPTABLE

Cracks: pass[☒] fail[ ]  
Undercut: pass[☒] fail[ ]  
Pin holes: pass[☒] fail[ ] ---  
Overlap (cold lap): pass[☒] fail[ ]  
Porosity (surface): pass[☒] fail[ ]  
Coloration: pass[☒] fail[ ]

Qualifier Hot Tube Date of Test Coupon 10-02-18

Welder Burckley Elliott Date of Test Coupon 10-02-18

The above named individual is qualified in accordance with AWS D17.1.2001 to weld